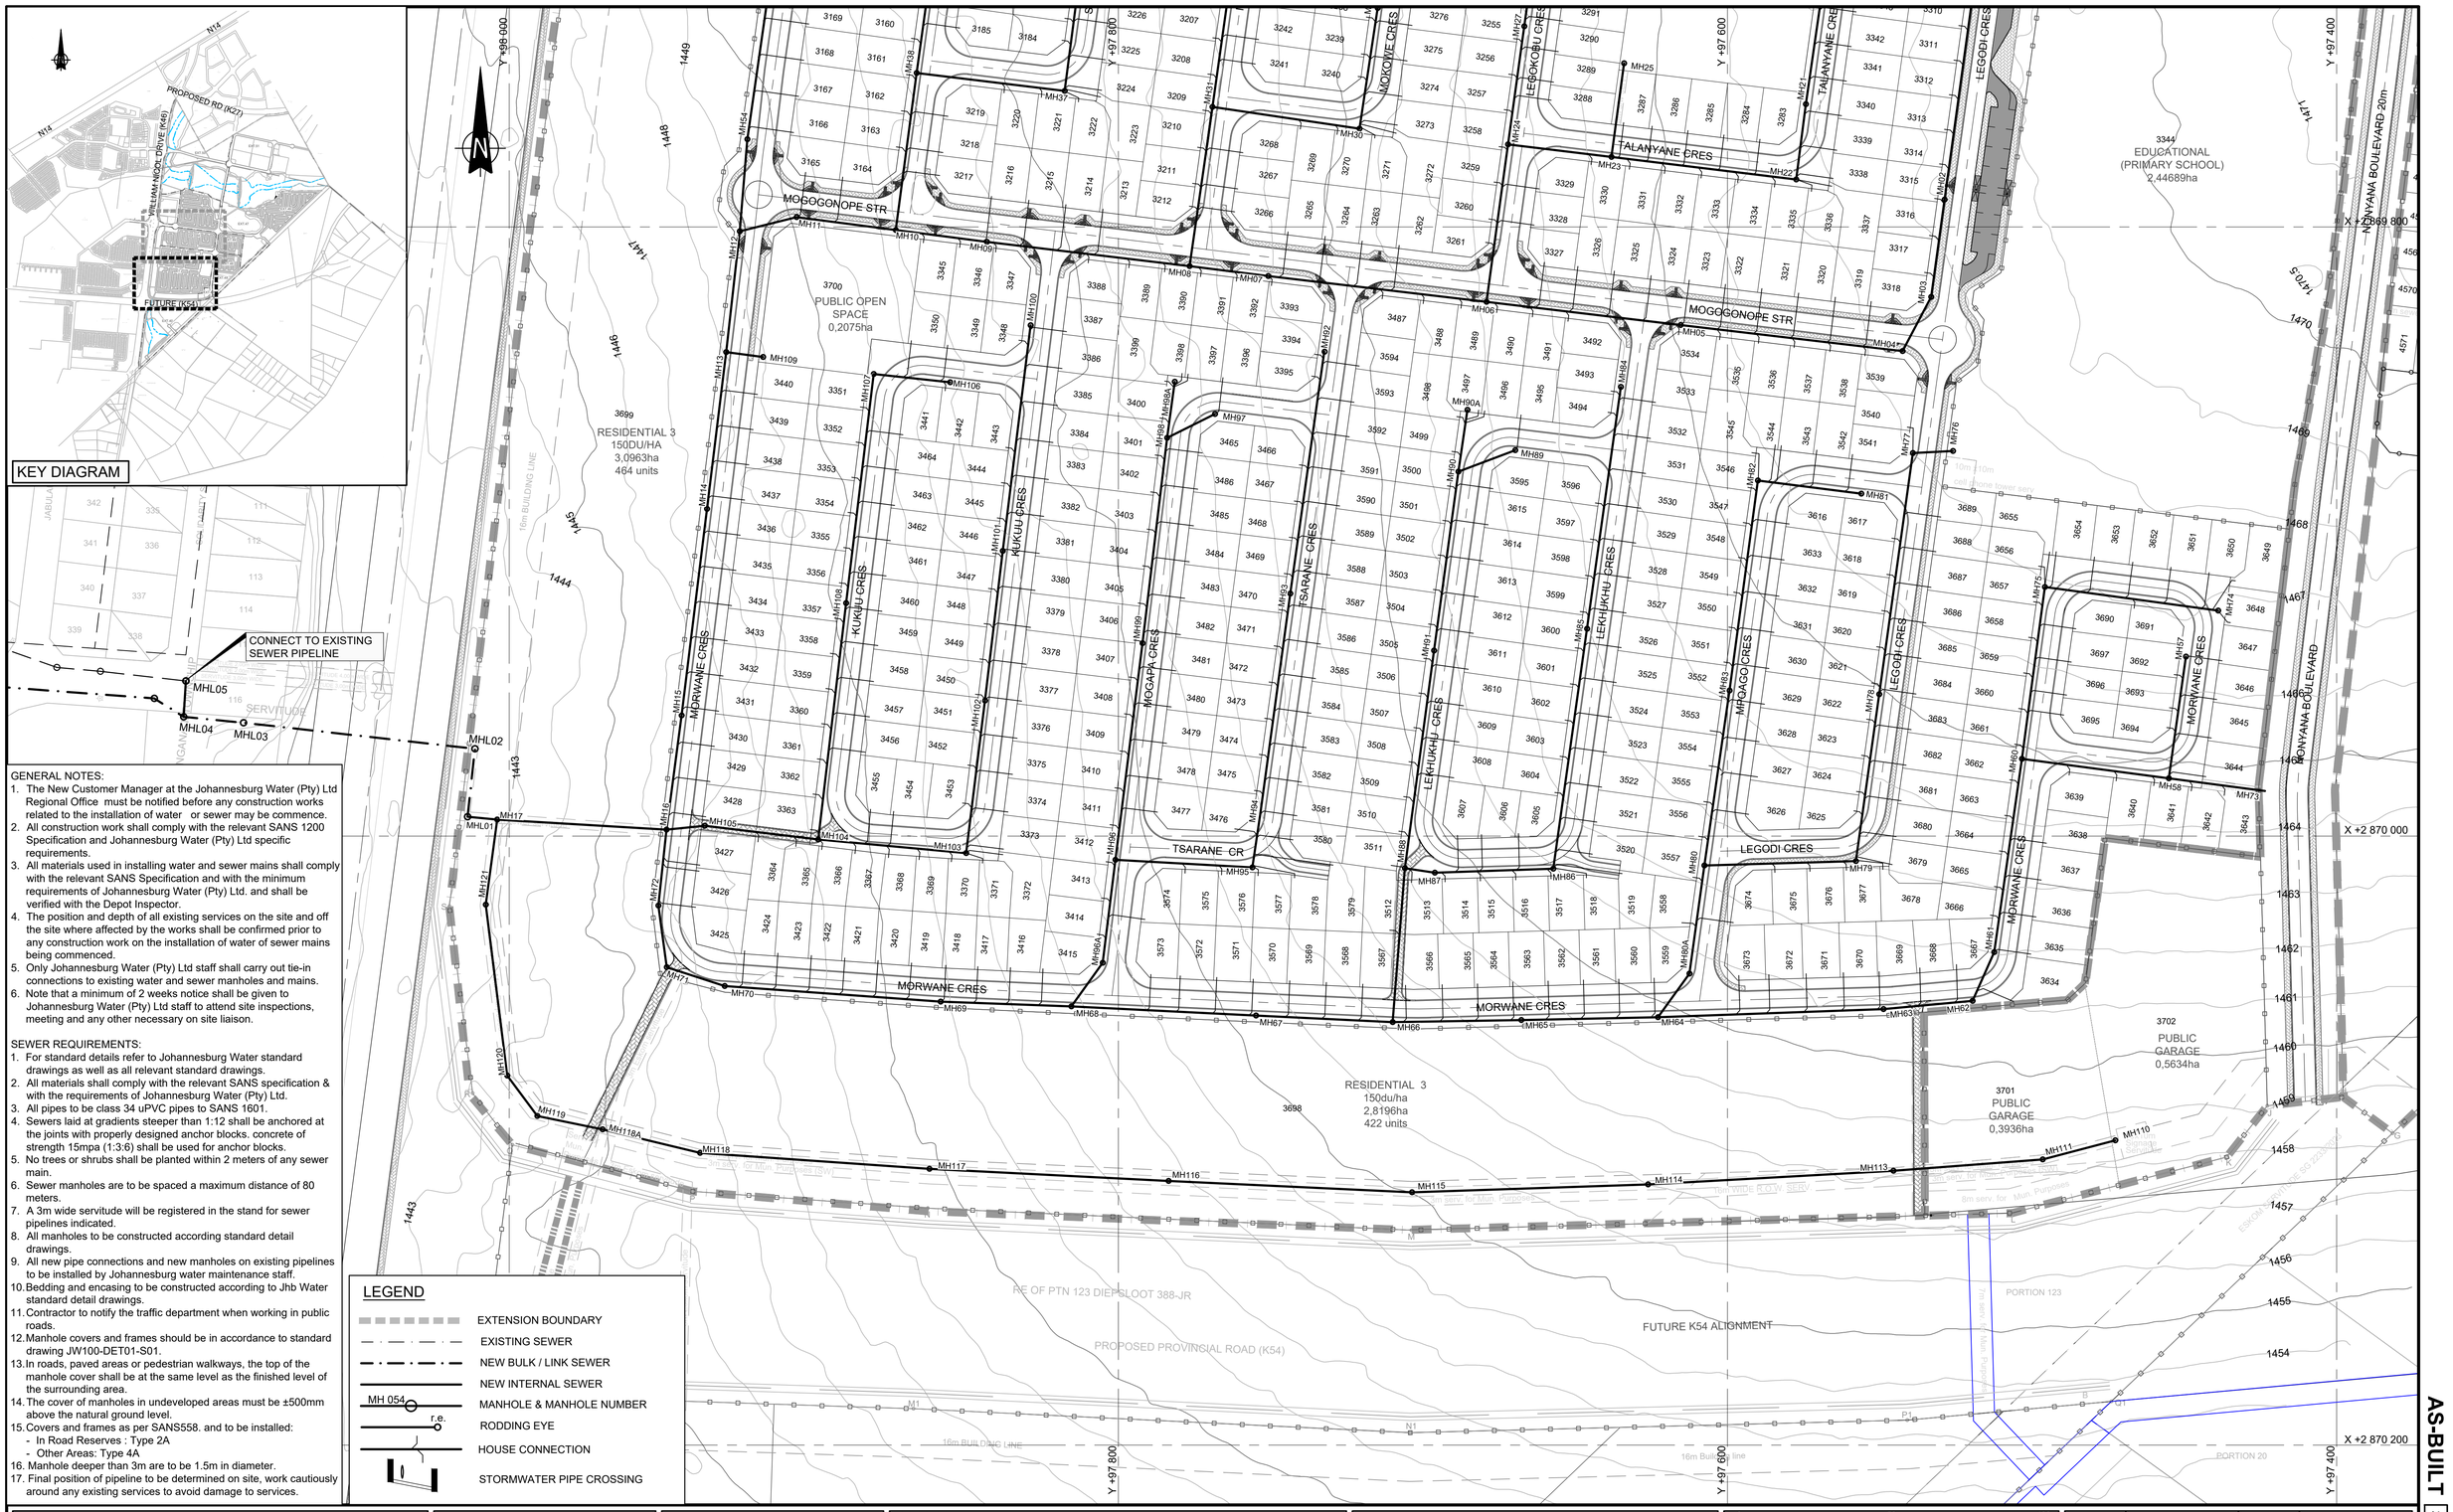

GENERAL NOTES:

1. The New Customer Manager at the Johannesburg Water (Pty) Ltd Regional Office must be notified before any construction works related to the installation of water or sewer may be commence.
2. All construction work shall comply with the relevant SANS 1200 Specification and Johannesburg Water (Pty) Ltd specific requirements.
3. All materials used in installing water and sewer mains shall comply with the relevant SANS Specification and with the minimum requirements of Johannesburg Water (Pty) Ltd. and shall be verified with the Depot Inspector.
4. The position and depth of all existing services on the site and off the site where affected by the works shall be confirmed prior to any construction work on the installation of water of sewer mains being commenced.
5. Only Johannesburg Water (Pty) Ltd staff shall carry out tie-in connections to existing water and sewer manholes and mains.
6. Note that a minimum of 2 weeks notice shall be given to Johannesburg Water (Pty) Ltd staff to attend site inspections, meeting and any other necessary on site liaison.

SEWER REQUIREMENTS:

1. For standard details refer to Johannesburg Water standard drawings as well as all relevant standard drawings.
2. All materials shall comply with the relevant SANS specification & with the requirements of Johannesburg Water (Pty) Ltd.
3. All pipes to be class 34 uPVC pipes to SANS 1601.
4. Sewers laid at gradients steeper than 1:12 shall be anchored at the joints with properly designed anchor blocks. concrete of strength 15mpa (1:3:6) shall be used for anchor blocks.
5. No trees or shrubs shall be planted within 2 meters of any sewer main.
6. Sewer manholes are to be spaced a maximum distance of 80 meters.
7. A 3m wide servitude will be registered in the stand for sewer pipelines indicated.
8. All manholes to be constructed according standard detail drawings.
9. All new pipe connections and new manholes on existing pipelines to be installed by Johannesburg water maintenance staff.
10. Bedding and encasing to be constructed according to Jhb Water standard detail drawings.
11. Contractor to notify the traffic department when working in public roads.
12. Manhole covers and frames should be in accordance to standard drawing JW100-DET01-S01.
13. In roads, paved areas or pedestrian walkways, the top of the manhole cover shall be at the same level as the finished level of the surrounding area.
14. The cover of manholes in undeveloped areas must be ±500mm above the natural ground level.
15. Covers and frames as per SANS558. and to be installed:
    - In Road Reserves : Type 2A
    - Other Areas: Type 4A
16. Manhole deeper than 3m are to be 1.5m in diameter.
17. Final position of pipeline to be determined on site, work cautiously around any existing services to avoid damage to services.

LEGEND

- EXTENSION BOUNDARY
- EXISTING SEWER
- NEW BULK / LINK SEWER
- NEW INTERNAL SEWER
- MH 054 — MANHOLE & MANHOLE NUMBER
- r.e. — RODDING EYE
- HOUSE CONNECTION
- STORMWATER PIPE CROSSING

VERSION / AMENDMENTS

No.	DATE	DESCRIPTION	AUTH. BY
2	06/2024	ISSUED FOR CONSTRUCTION	L.G
3	07/2024	SERVICE CO-ORDINATION UPDATED	L.G
4	08/2024	SERVICE UPDATED	L.G
5	04/2025	AS-BUILT DETAILS ADDED	L.G

SURVEY DATUM:

bigen
Doing good while doing business
www.bigengroup.com
Allan Cormack Street
The Innovation Hub
Persequor
Pretoria
Phone:+ 27 (0) 12 842 8700
pretoria@bigengroup.com

SAFDEV TANGANANI (PTY) LTD

Ballywoods Office Park,
33 Ballyclare Dr
Bryanston
Tel:+ 27 (0) 11 463 8882
Fax:+ 27 (0) 11 463 8838

PROJECT TITLE:

TANGANANI MEGA CITY PROJECT : PHASE 1

DRAWING TITLE:

EXTENSION 41
SEWER LAYOUT : SHEET 2

Johannesburg Water (Pty) Limited
Turbine Hall, 65 Ntembi Piliso street,
Newtown, JOHANNESBURG
TEL: 011-688-1600
FAX: 011-688-1529

0 50 100
100mm ON ORIGINAL DRAWING

ORIGINAL DRAWING SCALE:	1:1000	ORIGINAL DRAWING SHEET SIZE:	A1

SURVEYED		DESIGNED	M PHASHA
DRAWN	M STEENBERG		
COORD SYSTEM	WG29	DATE	JULY 2023

APPROVED ON BEHALF OF CLIENT:
NAME:
DATE:
CLIENT DRAWING No.:
CLIENT REF No.:

APPROVED ON BEHALF OF BIGEN:
PRACTITIONER:
REVIEWER:
DRAWING No.: **3522.10.00.GZA.06.U002**
VERSION: **5**

AS-BUILT

3522.10.00.GZA.06.U002